

This drawing contains information proprietary to Odor Control Specialties. It is submitted in confidence and is to be used solely for the purpose for which it is furnished. This drawing and such information is not to be reproduced, transmitted, disclosed or used otherwise in whole or in part without the written authorization of OCS.

Odor Control Specialties

120 E. 15th Avenue • N. Kansas City, MO 64116 • 1-877-279-4OCS (027)


Drawn 03-12-15

By: LJP

Scale: Not to Scale

Rev. As Built

OCS-ARVF40LB

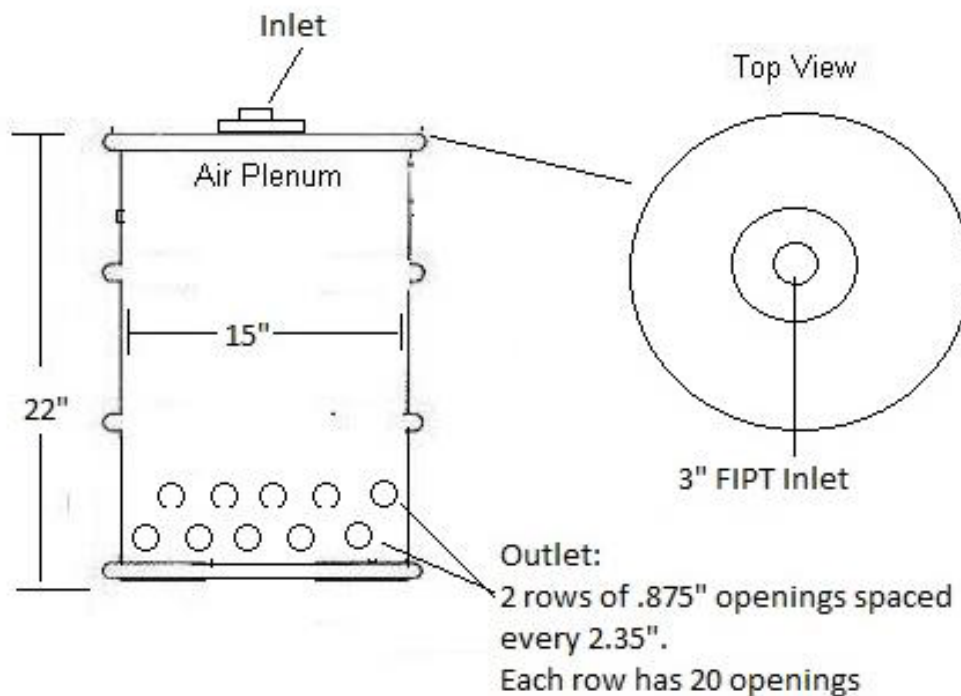

Open space inlet: 7.06 square inches

Open space outlet: 24 square inches

Specifications

Housing material	Polyethylene
Overall Height	24"
Top out side diameter	16"
Media Bed CF	1.6 Cubic Feet
Carbon Weight:,	40LBS. (Darco H2S)
Inlet	3" FIPT
Outlet	2 staggard rows of 7/8" holes spaced every 2.35" degrees
Flow Direction:	Down flow